



AMERICAN
STRUCTUREPOINT
INC.



LICKING COUNTY, OHIO HANOVER WATERLINE EXTENSION – PHASE 1

Recent Progress – (9-22-26 to 10-05-26)

- **SR-16 Jack-bore and pipe installation – 100% - Completed**
- **2-10” School Services for future on HAINSVIEW - 100% - Completed**
- **MARNE Rd. Services and Hydrant – 95% Completed**
- **Asphalt repair crew completed repairs on FLOWERS Drive**
- **LAMBS LANE – 100% Complete - Hydrants and Water Services**
- **12” Mainline crew on E MAIN – Installed 12” watermain back to the S from the SR-16 bore crossing, back toward E Main Street to prepare for Meter Vault installation and connection**

Week(s) Look Ahead – (10-06-26 to 10-20-26)

- **Pavement and Concrete Repair Crew – NOT anticipated on site**
- **RESTORATION crews to be announced for final topsoil leveling and seeding as needed by October 31st**
- **Licking Valley Rd. bore to NE side of MARNE Rd intersection, then RAILROAD crossing with a jack-bore**
-
- **E MAIN Street Meter Vault excavation and placement (likely watermain scheduled shut-off)**
- **MARNE Rd. 12” watermain tie-ins from completed waterway bores**
- **W HIGH/HICKMAN/S MAIN – potholing of utilities to install watermain by bore-method in this area as much as able**
- **Potable Water Testing on W and N side township side of project 8” watermain and for 12” watermain east of Bolen Rd. into village. Aiming for potable active water system as soon as 10/24 in those areas.**

Traffic Impacts. WORK HOURS can range from 730am – 7pm

1. W HIGH = Pothole efforts at HICKMAN and S MAIN may be in street from 9am-2pm with 1-lane 2-way traffic and flaggers, and anytime flaggers on Hickman and S Main.
2. E MAIN Street = 1-lane, 2-way traffic with flaggers during work hours AND anticipated partial day full closure when Meter Vault is delivered for installation.

Approx. project progress: 86.5% calendar (87 days of 639 days), 93.0% of pipe installed

***American Structurepoint Inc. - On behalf of the Licking County project please reach out to Field Inspection Contacts for project related items for the most rapid assistance, a project inspector is on-site to help facilitate, including concerns within Village and Township areas, please reach out as needed.

ON-SITE Inspector = Mark Campbell - 740-566-2021 - mcampbell@structurepoint.com

Sr. Project Representative = Jacob Brooks - 330-720-1505 - jbrooks@structurepoint.com

*****Residents/Property Owners please reach out to Inspector or Crew installing Water Service Boxes if staking for proposed Water Service location does not come into the correct side of house/business as your existing well system*****

E MAIN Street, City of Newark upcoming excavation for placing Meter Vault



HAINSVIEW 12" watermain with one of the 10" service crossings to school grounds near Panther Drive



MARNE Rd. repair to large unknown clay storm pipe near Licking Valley Rd intersection




Water testing box install on MONTGOMERY Rd. 1 of 4 Phase I install locations.



Receiving pit for Jack-bore under SR-16 on LAMBS LANE. North end of 24" steel casing pipe under SR-16 boot around 12" carrier watermain and bends to turn Easterly towards community of Hanover



PLOT SCALE: 1"=100' DATE: 5/15/26 - 10:59 AM EDITED BY: MAHMOUD DRAWING FILE: C:\2022\03\308D_DRAINING\SS\CVIL\CONSTRUCTION DOCUMENTS\2022.03308 CE CSP.DWG

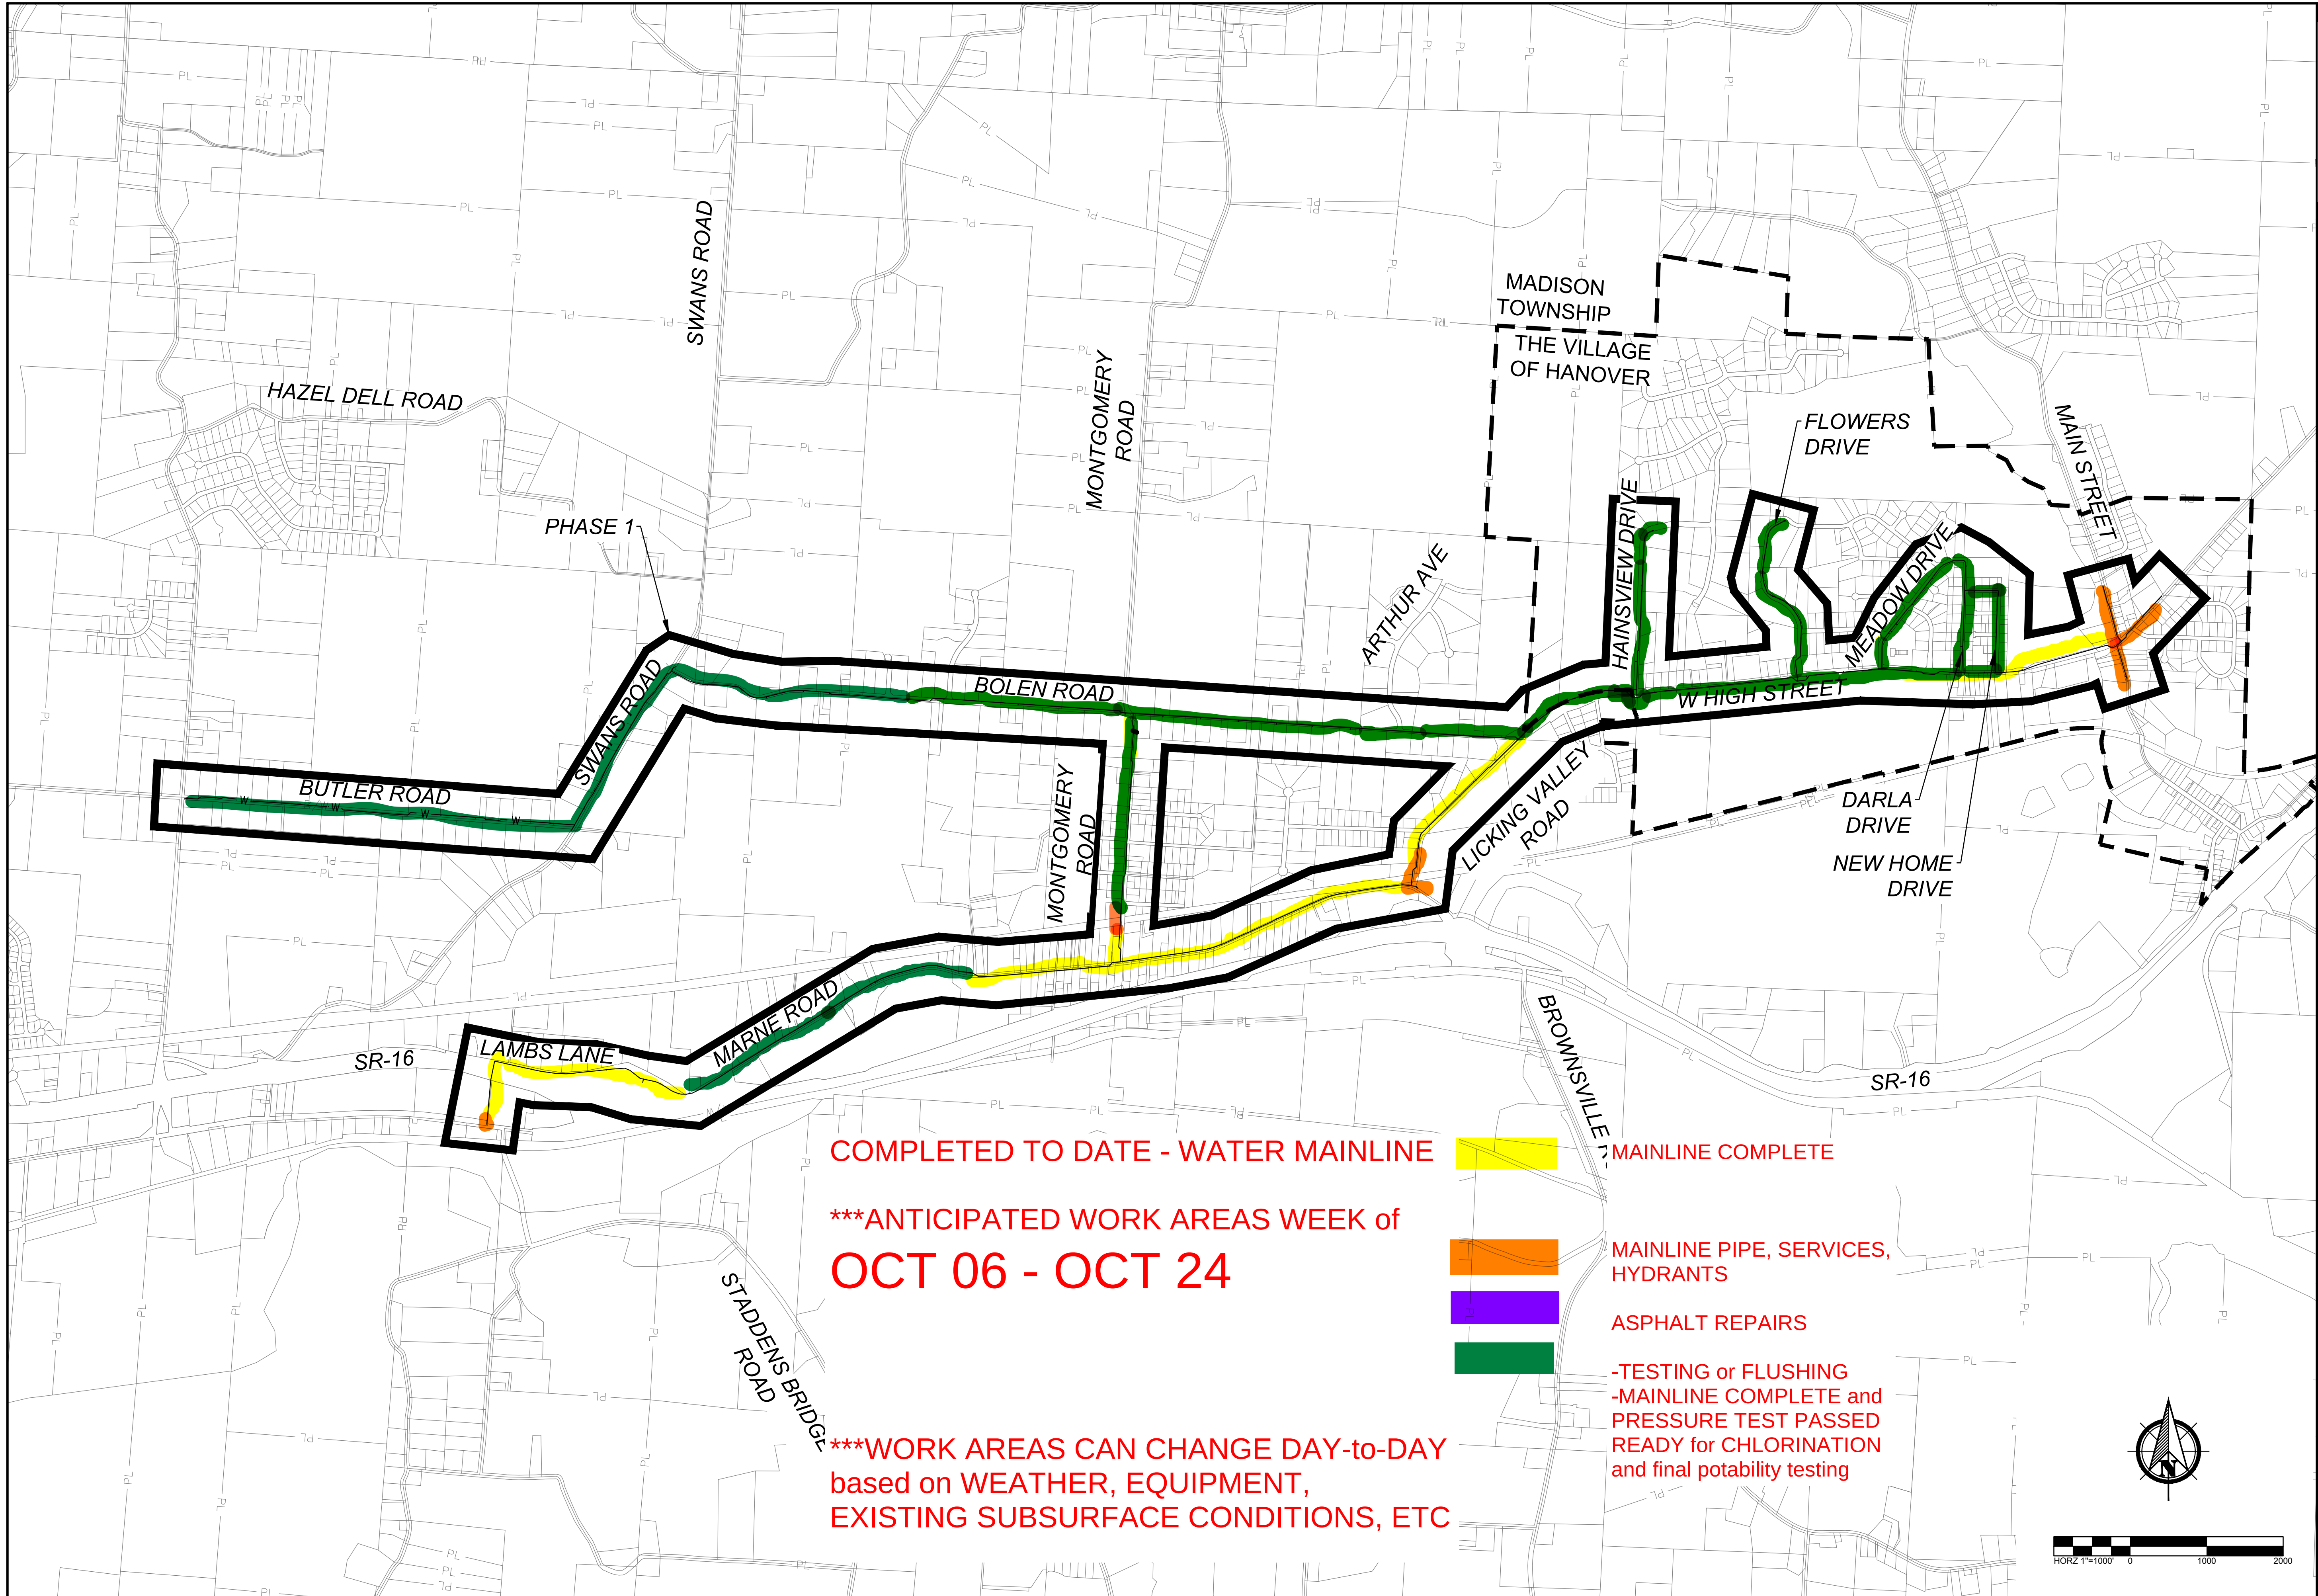


CONSTRUCTION DOCUMENTS
FOR
**HANOVER WATER EXTENSION
PHASE 1**
CITY OF HANOVER, LICKING COUNTY, OHIO
OVERALL PLAN

REVISIONS	DATE	SHEET NO.	DESCRIPTION

DATE:	5/15/2026
DRAWN BY:	MNA
CHECKED BY:	BJM
JOB NUMBER:	2022.03308

C100

PLOT SCALE: 1"=100' DATE: 5/15/26 - 11:00 AM EDITED BY: MAHMOUD DRAWING FILE: C:\2022\03\308D DRAWINGS\CIVIL\CONSTRUCTION\DOCUMENTS\ARCHIVE\2026-05-15\2022-03\308D CE OSPY.DWG

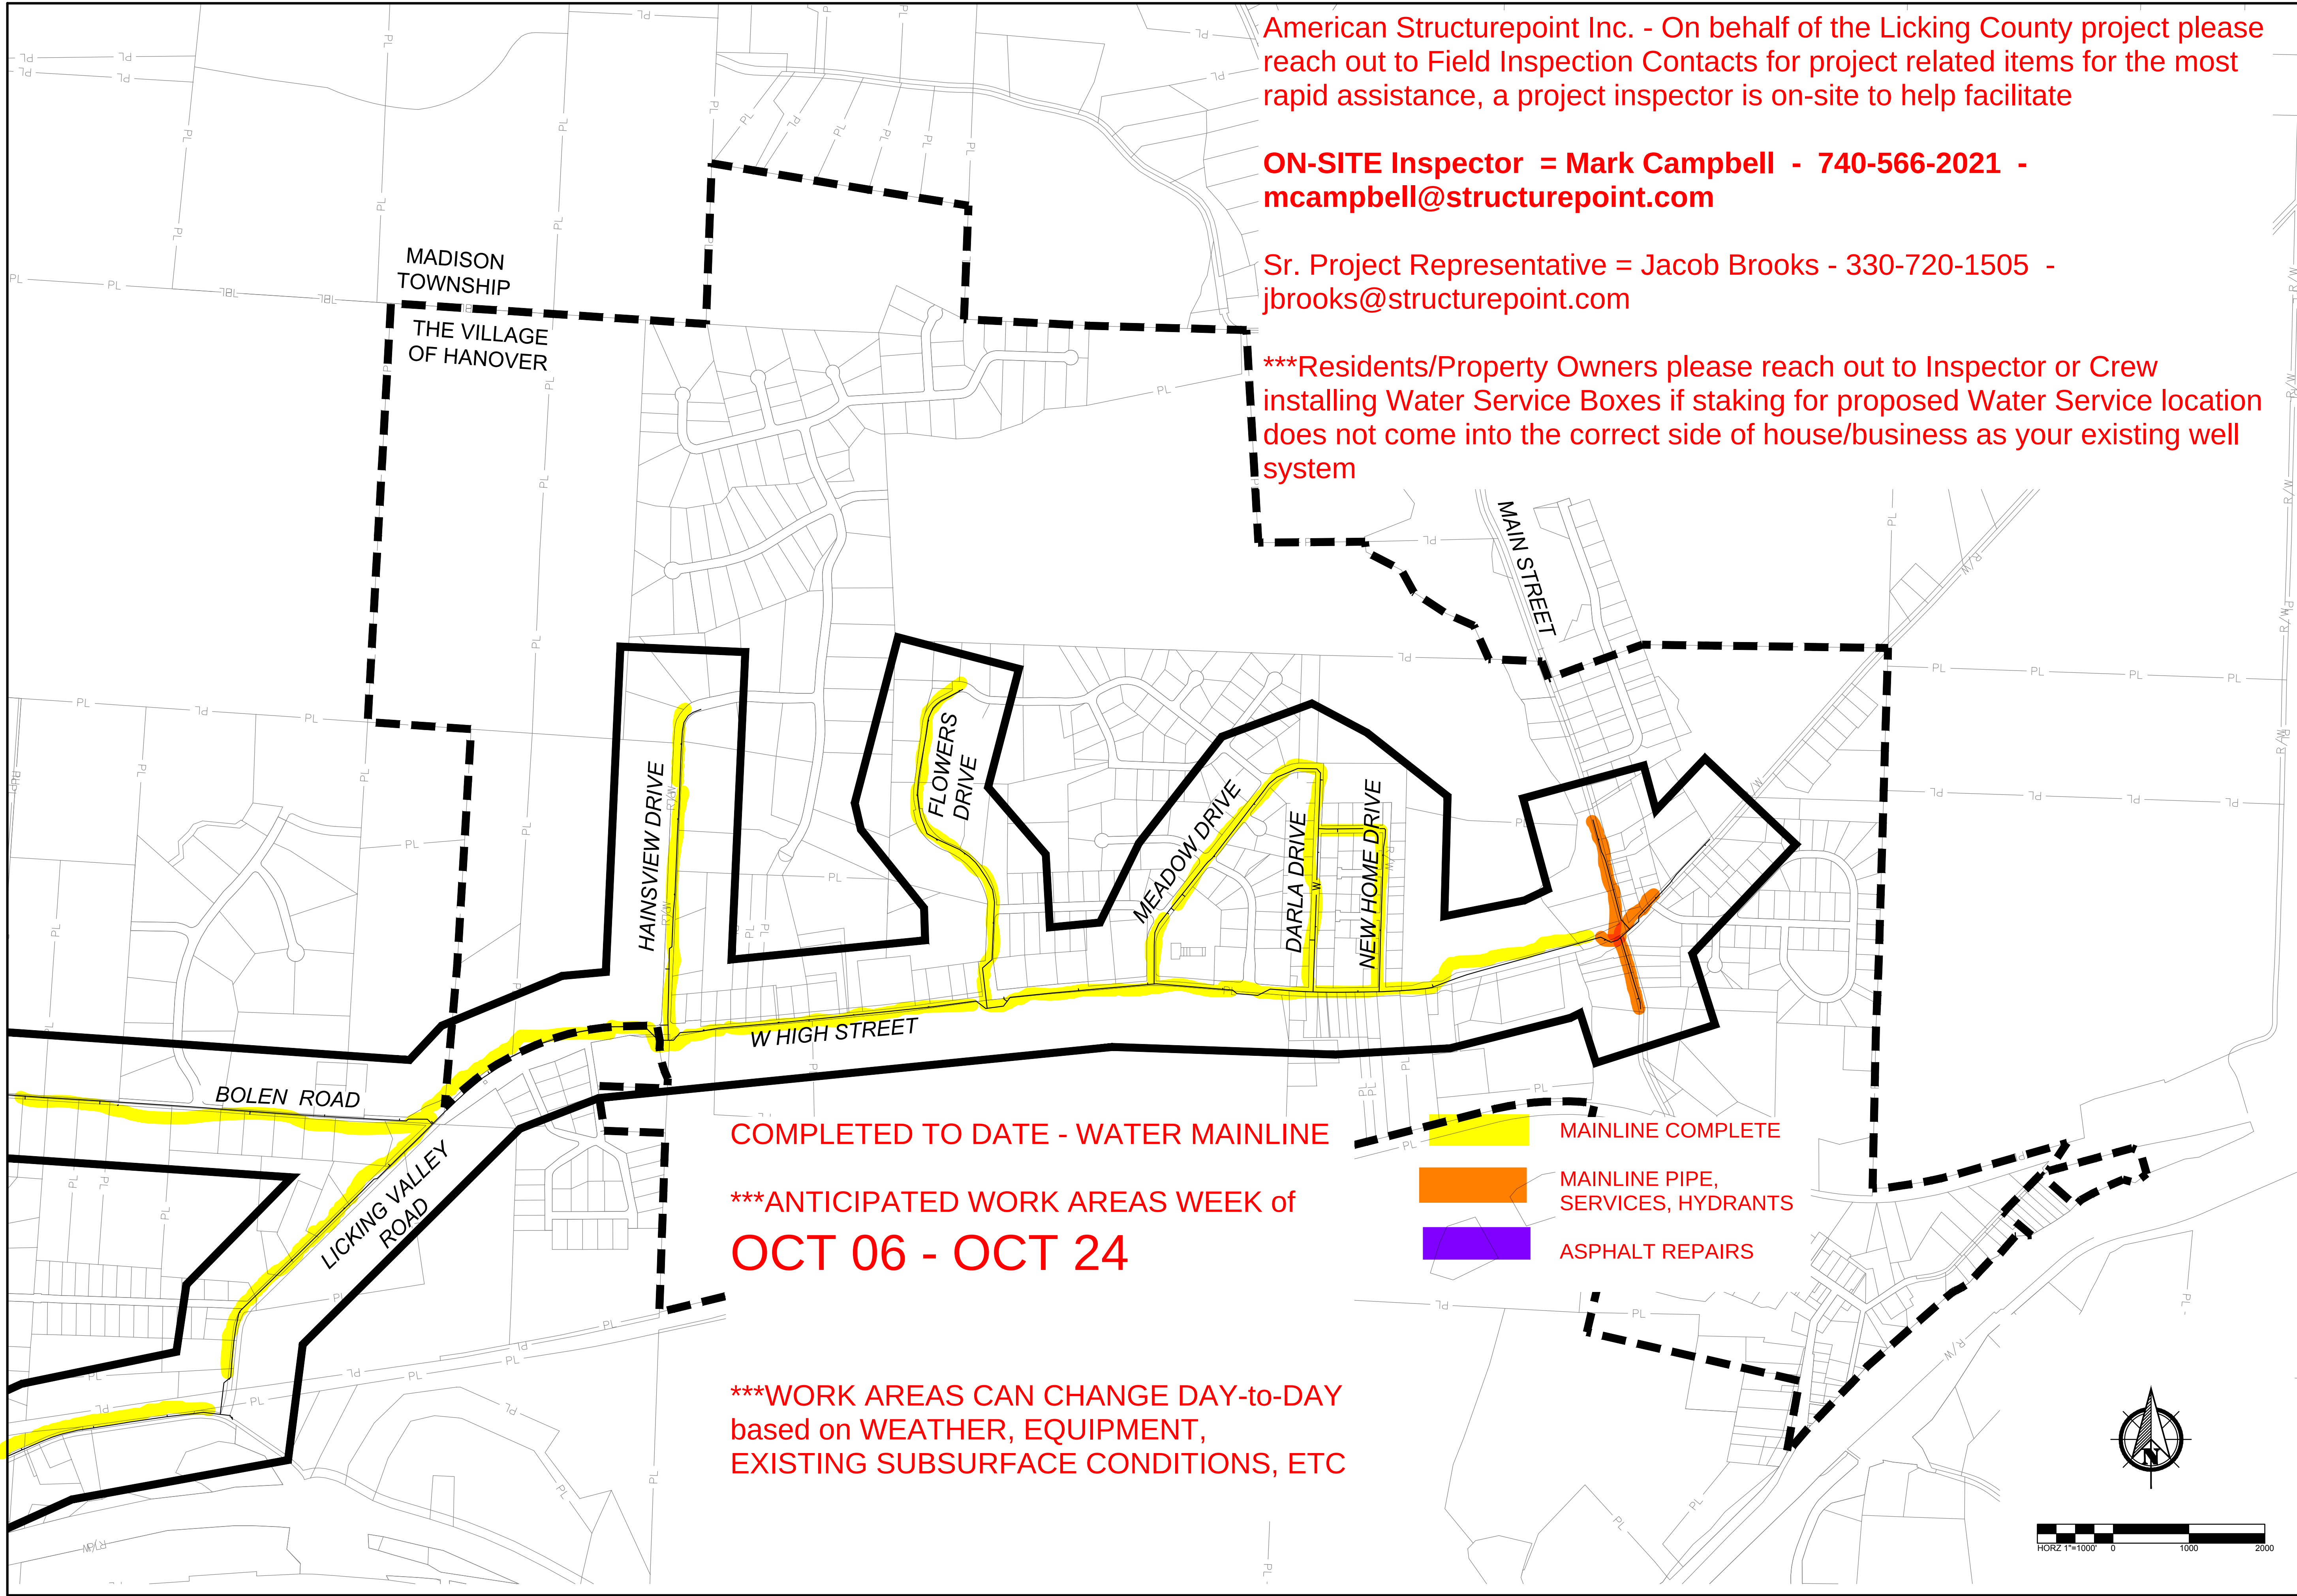

American Structurepoint Inc. - On behalf of the Licking County project please reach out to Field Inspection Contacts for project related items for the most rapid assistance, a project inspector is on-site to help facilitate

ON-SITE Inspector = Mark Campbell - 740-566-2021 - mcampbell@structurepoint.com

Sr. Project Representative = Jacob Brooks - 330-720-1505 - jbrooks@structurepoint.com

*****Residents/Property Owners please reach out to Inspector or Crew installing Water Service Boxes if staking for proposed Water Service location does not come into the correct side of house/business as your existing well system**



CONSTRUCTION DOCUMENTS
FOR
**HANOVER WATER EXTENSION
PHASE 1**
CITY OF HANOVER, LICKING COUNTY, OHIO
OVERALL PLAN

REVISIONS	DATE	SHEET NO.	DESCRIPTION

DATE:	5/15/2026
DRAWN BY:	MNA
CHECKED BY:	BJM
JOB NUMBER:	2022.03308

C100

